



Notice of Confirmation of a Modification Order

Wildlife and Countryside Act 1981

Dorset Council

County of Dorset Definitive Map and Statement of Rights of Way

**Dorset Council (Part of Footpath 30, Church Knowle at Charmswell)
Definitive Map and Statement Modification Order 2019**

On 5 January 2023, an Inspector appointed by The Secretary of State for Environment, Food and Rural Affairs confirmed, with modifications, the above-named order.

The effect of the order as confirmed will modify the definitive map and statement in the parish of Church Knowle by:

Deleting from them part of Footpath 30, Church Knowle – from the unaffected part of Footpath 30, in an area of scrub vegetation, north east of Charmswell at SY 93108203, south west across the garden of Charmswell and a small grass field, to rejoin the unaffected part of Footpath 30 at the field boundary at SY 93048199. (No recorded width).

Adding to them part of Footpath 30, Church Knowle - from the unaffected part of Footpath 30, in an area of scrub vegetation, north east of Charmswell at SY 93108203, south south east, across the garden and driveway of Charmswell to SY 93118200 then continuing west, across the garden and through a small grass field, to rejoin the unaffected part of Footpath 30 at the field boundary at SY 93048199. Width: 1.5 metres.

A copy of the order as confirmed and the order map have been placed and may be seen free of charge at Reception, County Hall, Colliton Park, Dorchester during normal office hours. Copies are also available on our website at www.dorsetcouncil.gov.uk/row-orders.

The order came into effect on 5 January 2023. If any person aggrieved by the Order desires to question its validity or that of any provision contained in it on the grounds that it is not within the powers of the Wildlife and Countryside Act 1981, or on the grounds that any requirement of the Act or of any regulation made under it has not been complied with in relation to the confirmation of the Order, you may within six weeks from 9 February 2023, make an application to the High Court.

Dated: 9 February 2023
Jonathan Mair, Monitoring Officer



**Dorset
Council**

Wildlife and Countryside Act 1981

Dorset Council

County of Dorset Definitive Map and Statement of Rights of Way

**Dorset Council (Part of Footpath 30, Church Knowle at Charmswell)
Definitive Map and Statement Modification Order 2019**

This Order is made by Dorset Council under section 53(2)(b) of the Wildlife and Countryside Act 1981 ("the Act") because it appears to that authority that the County of Dorset Definitive Map and Statement require modification in consequence of the occurrence of an event specified in section 53(3)(c)(i) namely, that a right of way which is not shown in the map and statement subsists or is reasonably alleged to subsist over land in the area to which the map relates and section 53(3)(c)(iii) namely, that any other particulars contained in the map and statement require modification.

that there is no public right of way over land shown in the map and statement as a highway of any description, or any other particulars contained in the map and statement require modifications.

The authority have consulted with every local authority whose area includes the land to which the Order relates. Dorset Council hereby order that:


1. For the purposes of this Order the relevant date is 13 September 2019.
2. The County of Dorset Definitive Map and Statement shall be modified as described in Part I and Part II of the Schedule and shown on the map attached to the Order.
3. This Order shall take effect on the date it is confirmed and may be cited as the "Dorset Council (Part of Footpath 30, Church Knowle at Charmswell) Definitive Map and Statement Modification Order 2019".

Dated this **25TH** day of **OCTOBER** 2019

THE COMMON SEAL OF
DORSET COUNCIL
was fixed in the presence of:-

Coram Hai

446/19

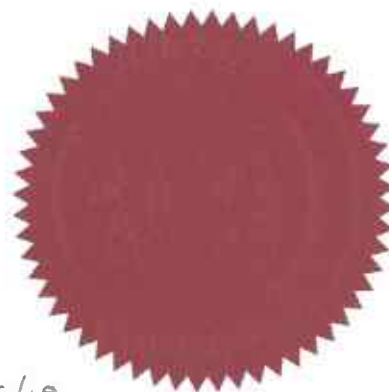

Authorised Signatory

The foregoing order is hereby confirmed
subject to the red ink modifications thereon

A Spencer-Peet 5 JAN 2023

An Inspector appointed by The Secretary
of State for Environment, Food and
Rural Affairs

SCHEDULE

(The points specified relate to the map attached to the Order and their positions are identified by national grid references)

Part I

Modification of definitive map Description of path to be deleted

Part of Footpath 30, Church Knowle:

- A – B From the unaffected part of Footpath 30, in an area of scrub vegetation, north east of Charmswell at point A (SY 93108203), south west across the garden of Charmswell and a small grass field, to rejoin the unaffected part of Footpath 30 at the field boundary at point B (SY 93048199). (No recorded width).

Description of path to be added

Part of Footpath 30, Church Knowle:

- A – C – B From the unaffected part of Footpath 30, in an area of scrub vegetation, north east of Charmswell at point A (SY 93108203), south south east, across the garden and driveway of Charmswell to point C (SY 93118200), then continuing west, across the garden and through a small grass field, to rejoin the unaffected part of Footpath 30 at the field boundary at point B (SY 93048199). Width: 1.5 metres.

Part II

Modification of definitive statement Variation of particulars of path


Footpath 30, Church Knowle:

Delete:

From: 930821 To: 921816 *stet*
County road north of Cocknowle via ~~Bare Cross~~ to Steeple parish boundary.

Add: *SY 93088207* To: *SY 92128163*
From: ~~SY 930821~~ To: ~~SY 921816~~

County road north of Cocknowle via ~~Bare Cross~~, generally south east to SY 93108203, south south east, across the garden and driveway of Charmswell to SY 93118200 then continuing west, across the garden and through a small grass field, to SY 93048199. Continue generally west south west to Steeple parish boundary. Width: 1.5 metres between SY 93108203 and SY 93048199.

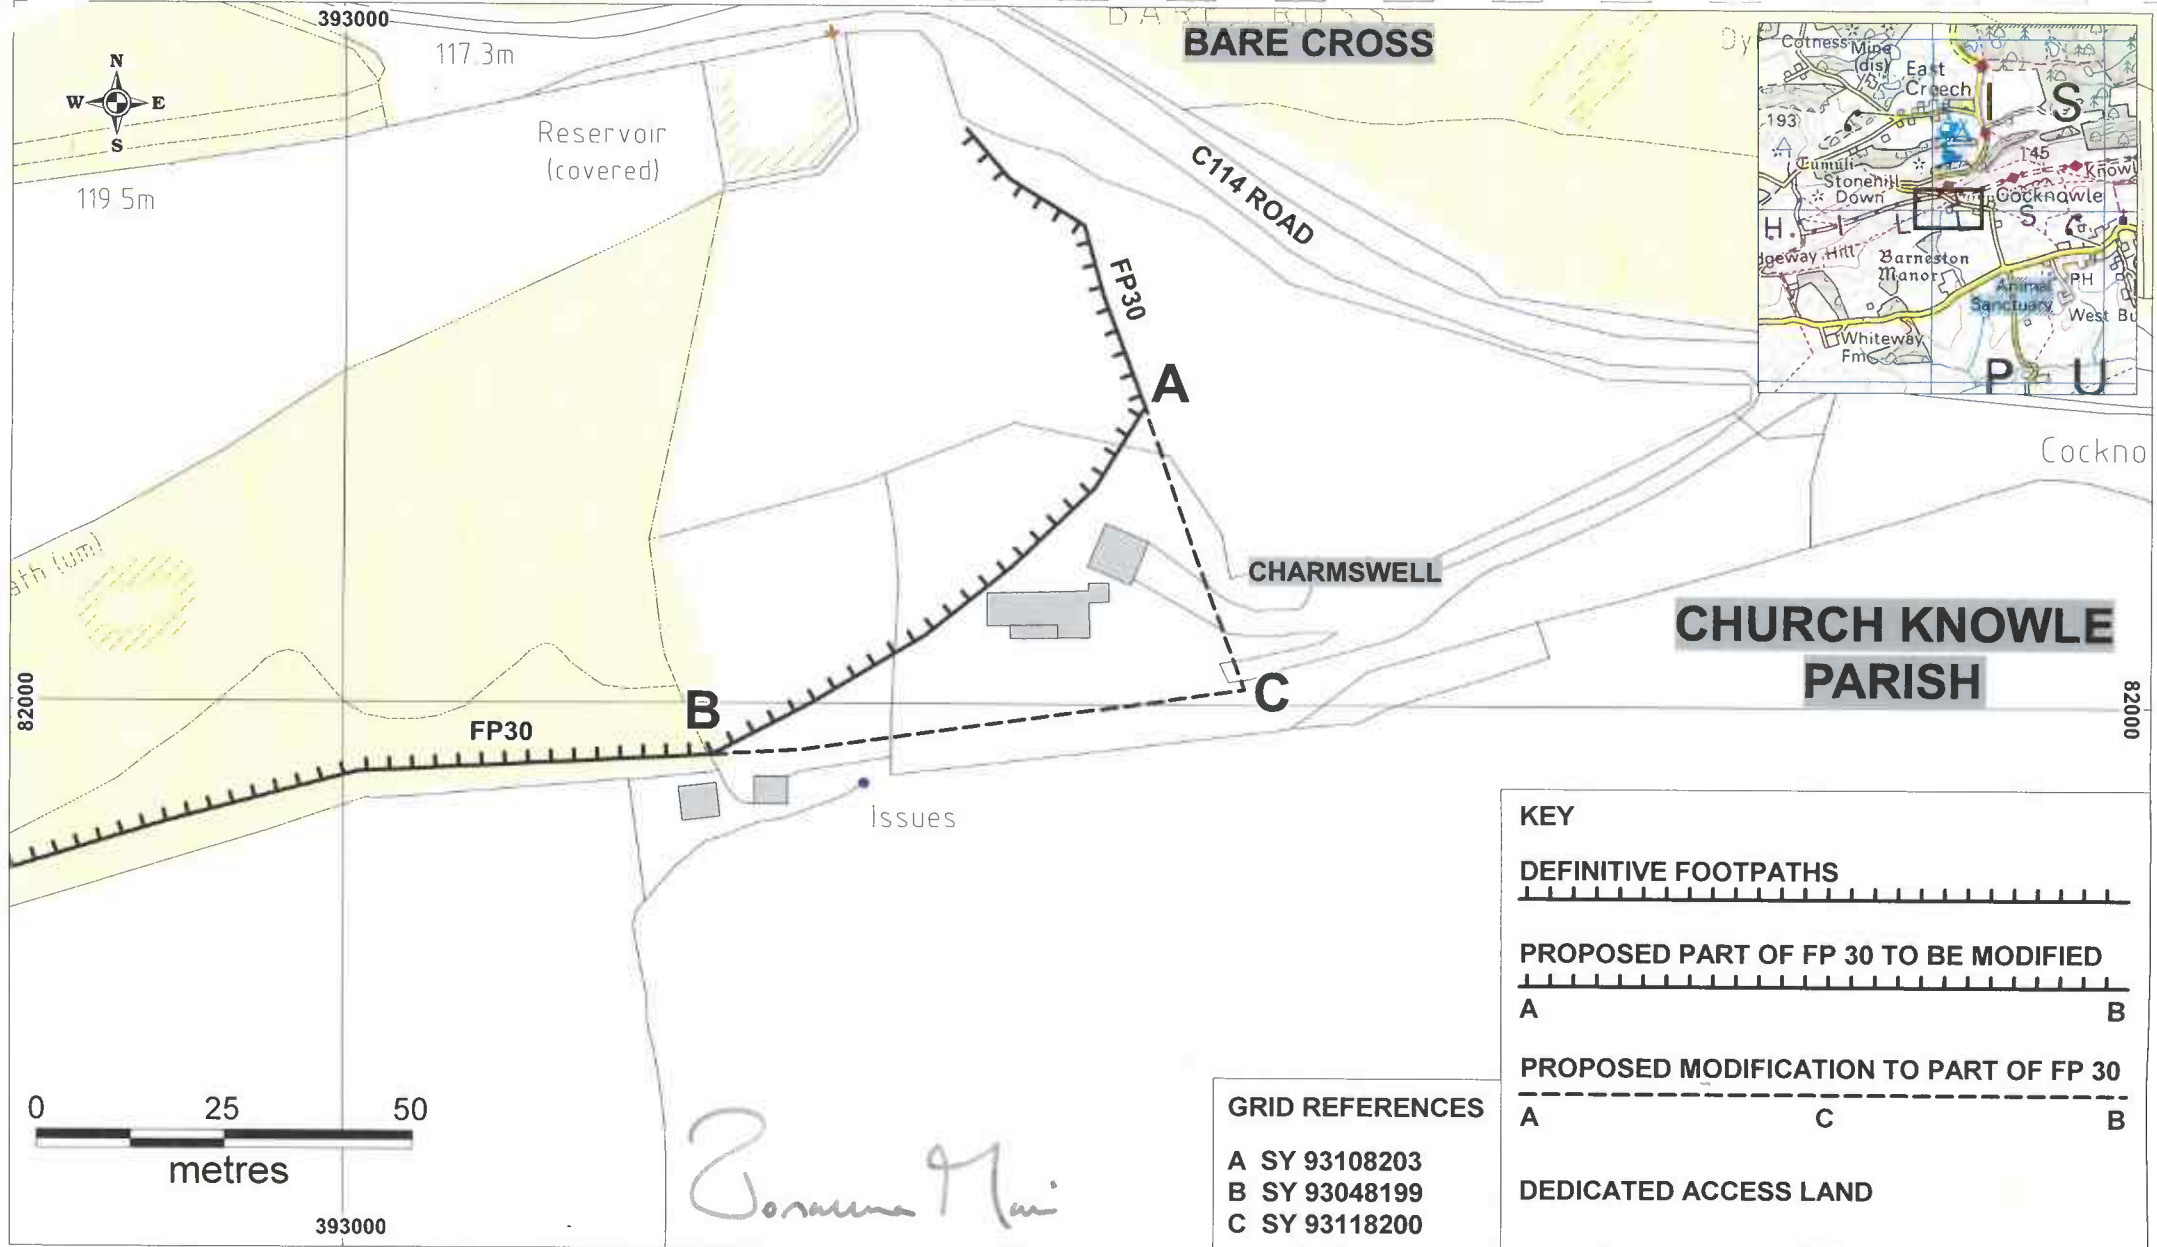

| KEY | |
|---|----------|
| DEFINITIVE FOOTPATHS | |
| | |
| PROPOSED PART OF FP 30 TO BE MODIFIED | |
| A | B |
| PROPOSED MODIFICATION TO PART OF FP 30 | |
| A | B |
| C | B |
| DEDICATED ACCESS LAND | |

| GRID REFERENCES | |
|-----------------|-------------|
| A | SY 93108203 |
| B | SY 93048199 |
| C | SY 93118200 |

DORSET COUNCIL (PART OF FOOTPATH 30, CHURCH KNOWLE AT CHARMSWELL) DEFINITIVE MAP AND STATEMENT MODIFICATION ORDER 2019

Ref: 14/44
Date: 05/02/2015
Scale 1:1000
Drawn By: ACWH
Cent X: 393079
Cent Y: 82010

Dorset Council

© Crown Copyright and database rights 2019 Ordnance Survey 010060963
 You are permitted to use this data solely to enable you to respond to, or interact with, the organisation that provided you with the data. You are not permitted to copy, sub-licence, distribute or sell any of this data to third parties in any form.
 Aerial Photography © UK Perspectives 2002 & © Getmapping 2005, 2009 & 2014
 Getmapping Plc and Bluesky International Limited [2017]